


SETTLEMENT MONUMENT ELEVATIONS

MON. NO.	ELEVATION 11/23/98	ELEVATION 11/08/99	ELEVATION 11/01/00
1	271.14	270.93	270.86
2	264.43	264.28	264.27
3	265.35	265.20	265.20
4	269.99	269.83	269.82
5	270.30	270.14	270.13
6	274.06	273.87	273.83
7	293.21	292.84	292.68
8	292.69	292.28	292.11
9	294.39	294.06	293.92
10	292.37	291.93	291.78
11	298.87	298.45	298.27
12	292.81	292.44	292.32
13	292.76	292.35	292.20
14	258.13	258.02	258.01
15	258.87	258.75	258.73
16	255.58	255.46	255.45

SYMBOL LEGEND

- SETTLEMENT MONUMENT
- ⊙ GAS VENT
- EDGE OF LINER MARKER
- ⊙ GAS MONITORING STATION
- ⊙ MONITORING WELL
- ⊙ HYDRANT
- ⊙ WATER VALVE
- ⊙ DRAIN MAN HOLE
- ⊙ CATCH BASIN
- ⊙ UTILITY POLE
- ⊙ GRANITE BOUND
- ⊙ UTILITY BOX

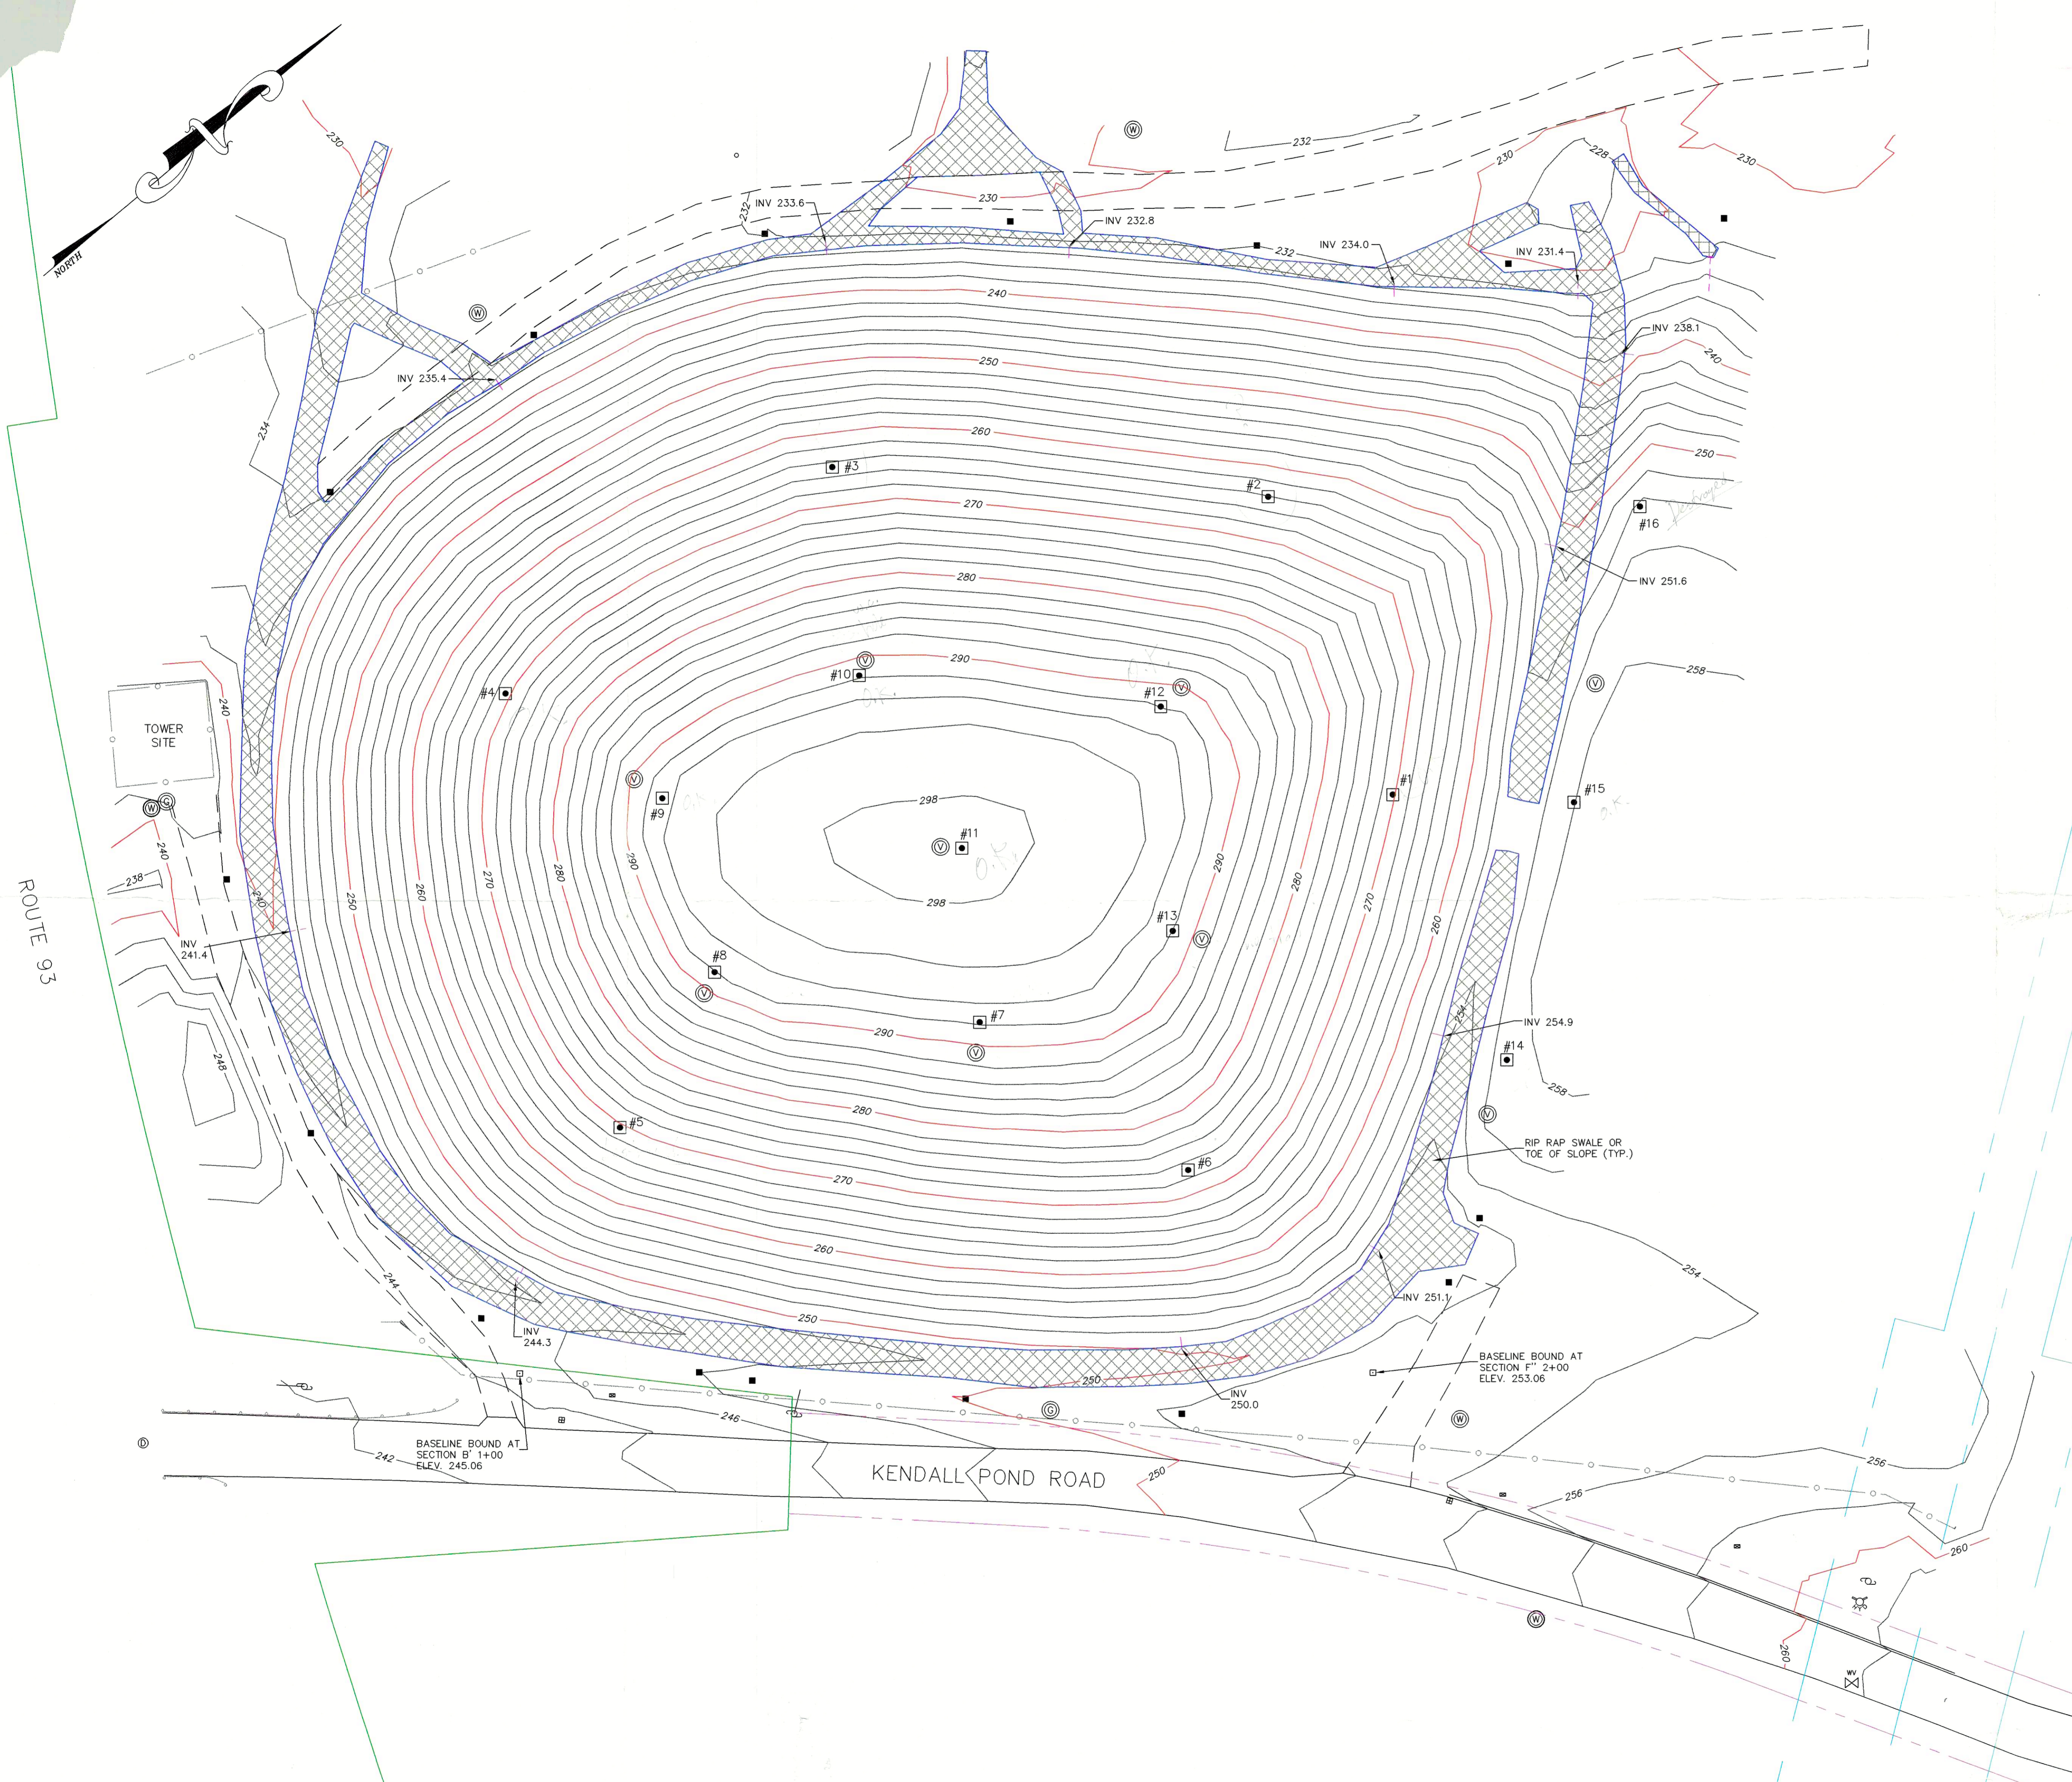

NO.	DATE	DESCRIPTION	BY
2	11/01/00	ADDED NEW ELEVATIONS	SNK
1	11/08/99	ADDED NEW ELEVATIONS	SNK

As-Built Survey Plan for
Town of Derry, N.H.
 Kendall Pond Road
 Derry, New Hampshire
 Scale 1"=40' December 18, 1998

 **New Hampshire Geomatics, Inc.**
 PO Box 5127, Manchester, NH 03108-5127
 603-668-8848



800-L-681